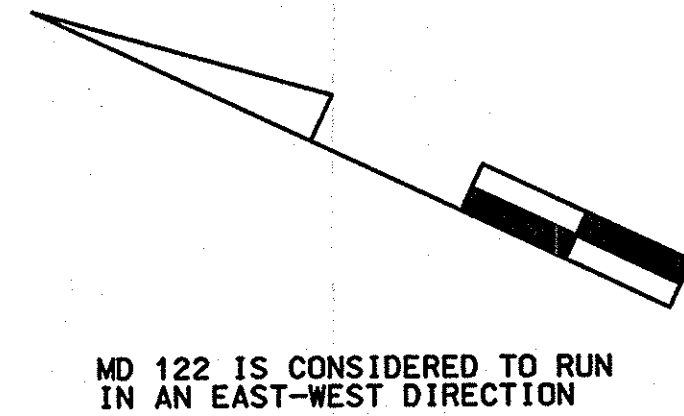


DRILL HOLES


DRILL HOLES

DRILL HOLES


BORDER REV. DATE: June 1, 2004

MD 122 IS CONSIDERED TO RUN
IN AN EAST-WEST DIRECTION


EXISTING SIGNS

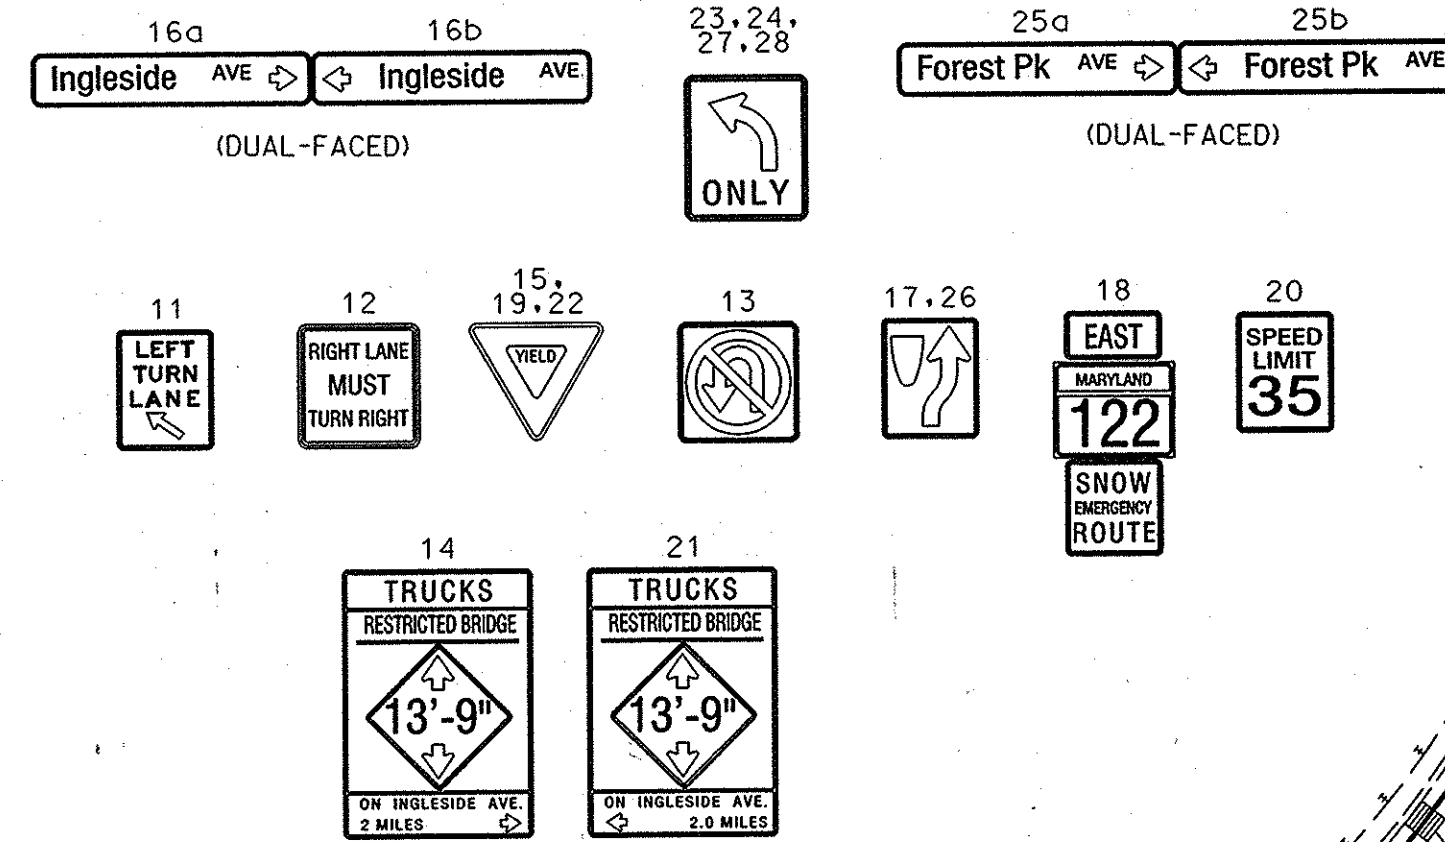

EXISTING SIGNALS

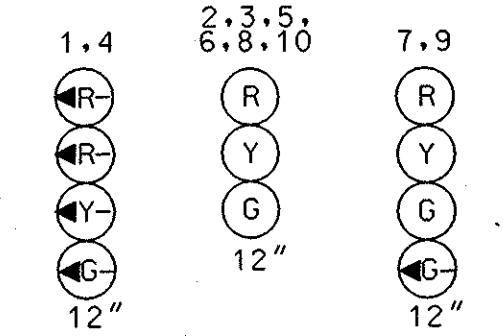

NEMA PHASING

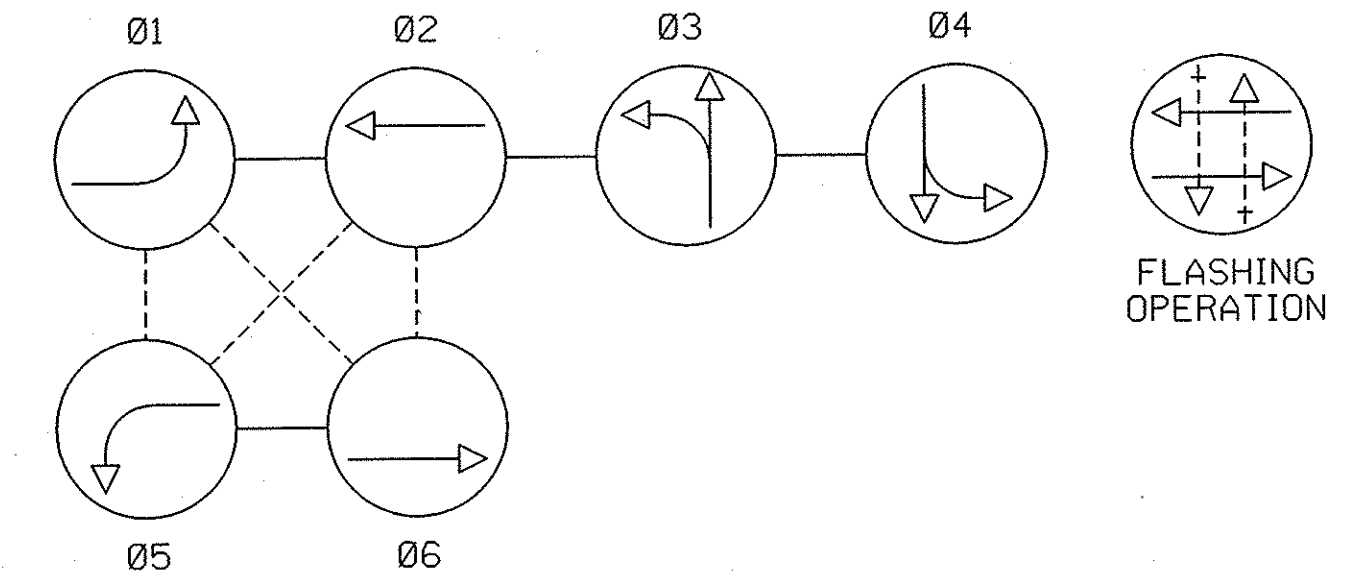

PHASING NOTES:

- 1.) PHASES ASSOCIATED BY A DASHED LINE WILL OPERATE CONCURRENTLY
- 2.) PHASES ASSOCIATED BY A SOLID LINE WILL NOT OPERATE CONCURRENTLY

MD 122 (SECURITY BLVD)

MD 122 (SECURITY BLVD)


EQUIPMENT DETAILS

- 12" x 30' steel strain pole, control and distribution equipment with 2-3" weatherheads. (Note: 4-2" polyvinyl chloride bends).
- 12" x 30' steel strain pole with 1-2" weatherhead. (Note: 1-1 1/2" 90° polyvinyl chloride bend).
- 12" x 30' steel strain pole with pole mounted sign and 1-2" weatherhead. (Note: 1-1 1/2" 90° polyvinyl chloride bend).
- NEMA size "5" base-mounted cabinet and controller with all necessary equipment. (Note: 3-2" polyvinyl chloride bends).
- 3/8" steel span wire, traffic signal heads and sign(s).
- 6' x 30' loop detector encased in 1/4" flexible tubing quadrupole type (3-6-3).
- 6' x 6' loop detector encased in 1/4" flexible tubing (4-turns).
- Baltimore County (round) handhole.
- 1 1/2" polyvinyl chloride electrical conduit.
- 2" Polyvinyl chloride electrical conduit.
- 2" galvanized steel electrical conduit.
- Existing overhead electrical service maintained by BGE.

GEOMETRIC LEGEND	
PROPOSED	---
EXISTING	---
LEGEND OF UNDERGROUND AND OVERHEAD UTILITIES	
AERIAL CABLE	---
ELECTRIC	---
TELEPHONE	---
GAS	---
SEWER	---
WATER	---
CABLE TV	---

BGE POLE #
293053

INGLESIDE AVE

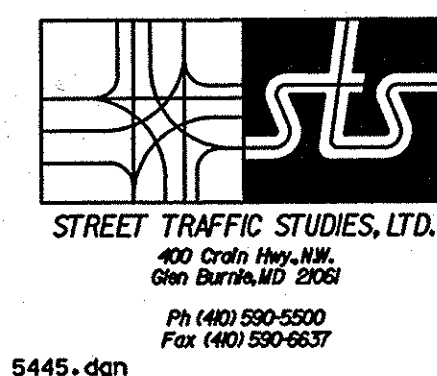

GENERAL NOTES:

- This plan reflects only those underground utilities that were apparent at the time of this location being asbuilt. A detailed review was not undertaken and the plan should not be construed as representing all underground utilities in the area.
- Any modification to this subject signal should be preceded by a thorough identification of all existing utilities.

SHA STATE OF MARYLAND
DEPARTMENT OF TRANSPORTATION
STATE HIGHWAY ADMINISTRATIONMD 122 (SECURITY BLVD) AND
N.FOREST PARK AVE / INGLESIDE AVE

TRAFFIC SIGNAL PLAN

SCALE 1"= 20' DATE 10-17-1962 CONTRACT NO.

DESIGNED BY BALTIMORE COUNTY COUNTY BALTIMORE

DRAWN BY LOGMILE 03012202.59

CHECKED BY TMS NO.

F.A.P. NO. TOD NO.

TS NO. (4696D) DRAWING NO. 1 OF 1 SHEET NO. OF

PLOTTER: #DATEIME#
FILE: #FILE#

... 03000 5154515452.dgn 10/28/2008 3:05:13 PM